


Contractor to confirm all exterior colors w/ Owner prior to ordering material / performing work. Proposed colors represents Architect's recommendations (unless project is located in district which controls exterior colors).

A310.00 **Reference Sheets**
(if provided)


Fire Rating
see A500 sheets for Fire Rating certification/
tests for all materials listed with fire rating.

Mechanical Fixtures/Equipment
see E100 Sheets for Mechanical Equipment
Specifications

Lighting
see E200 Sheets for Exterior Lighting + Switch
Locations

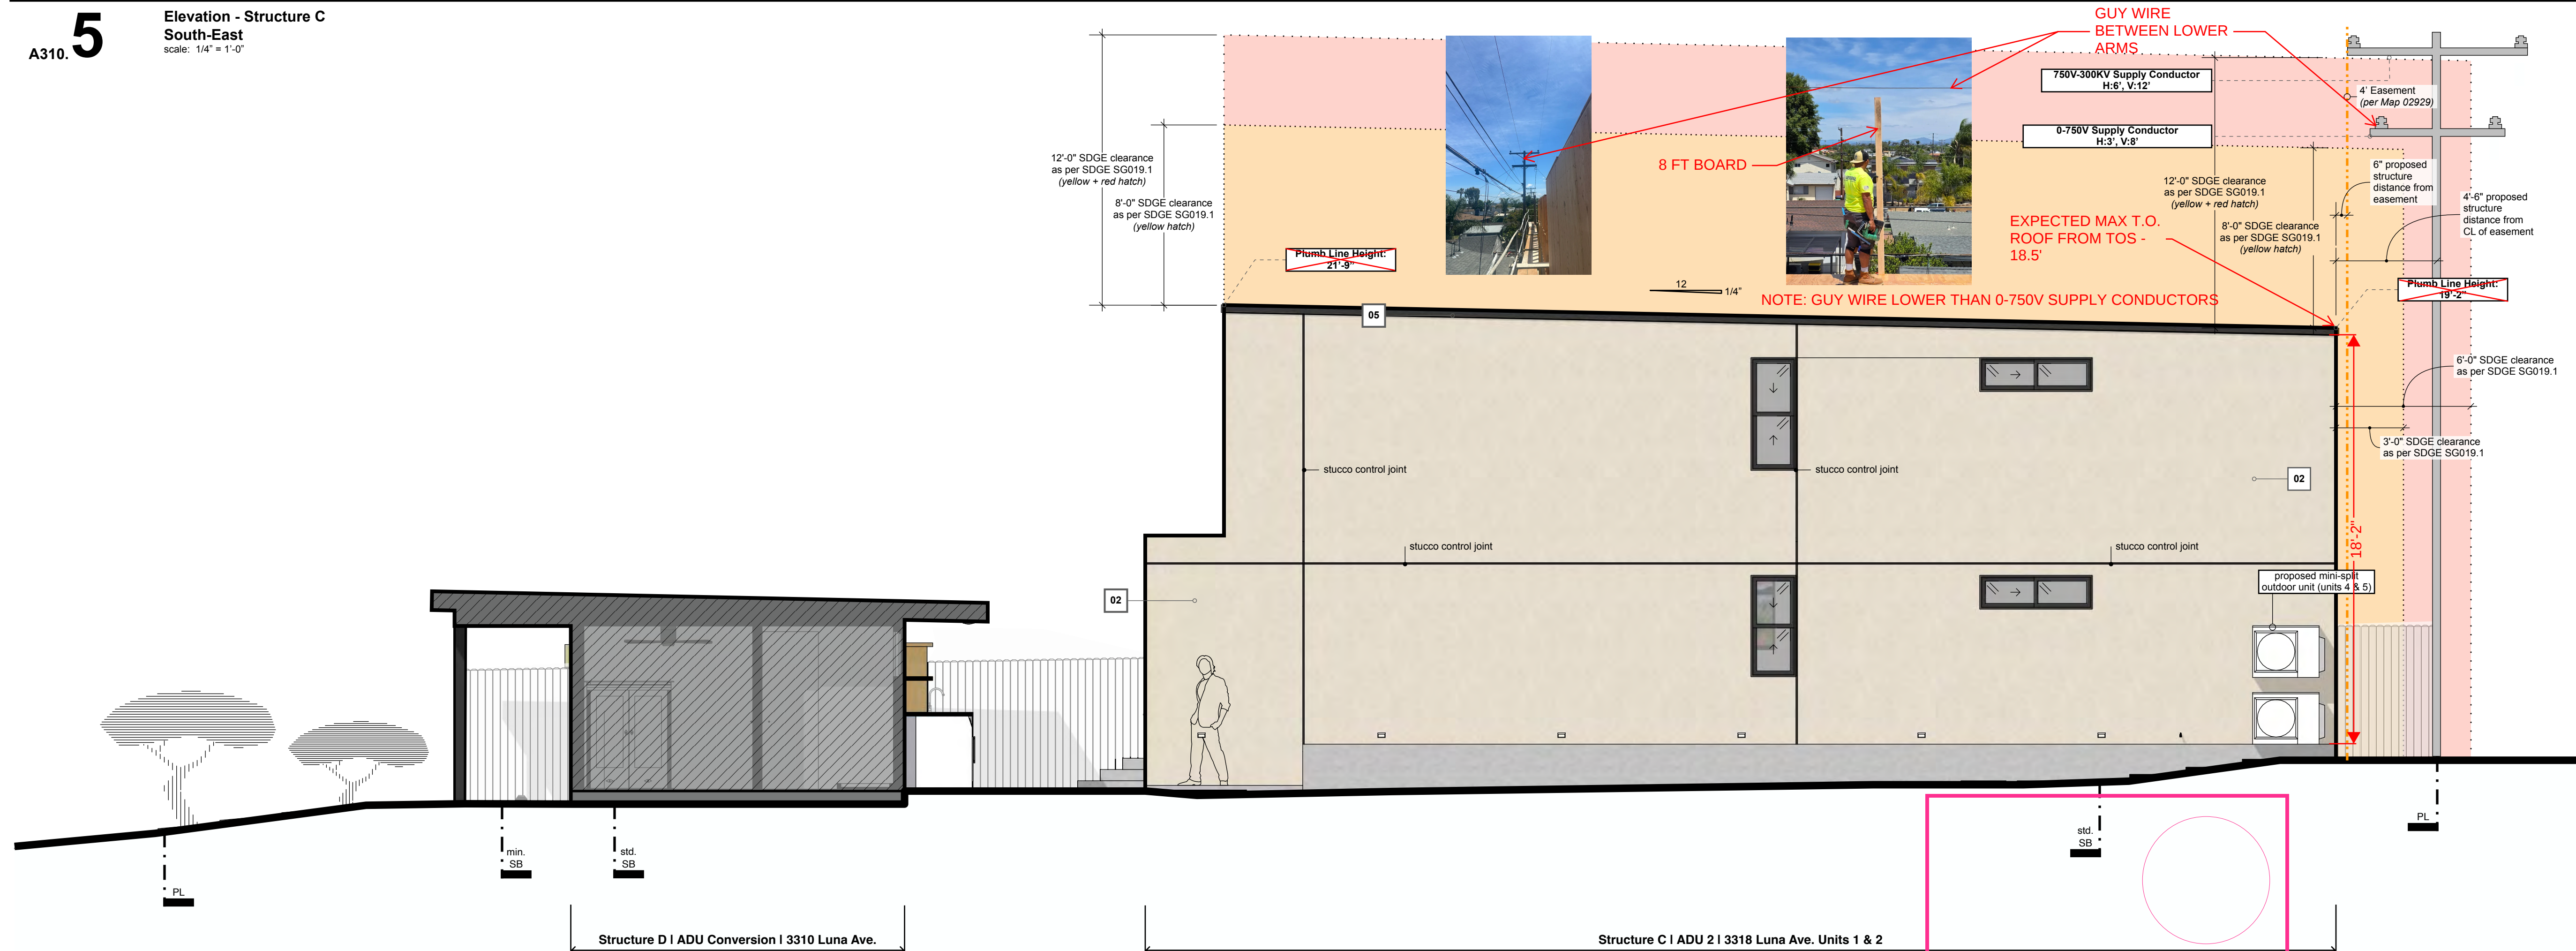

A310. 5 Elevation - Structure C
South-East
scale: 1/4" = 1'-0"

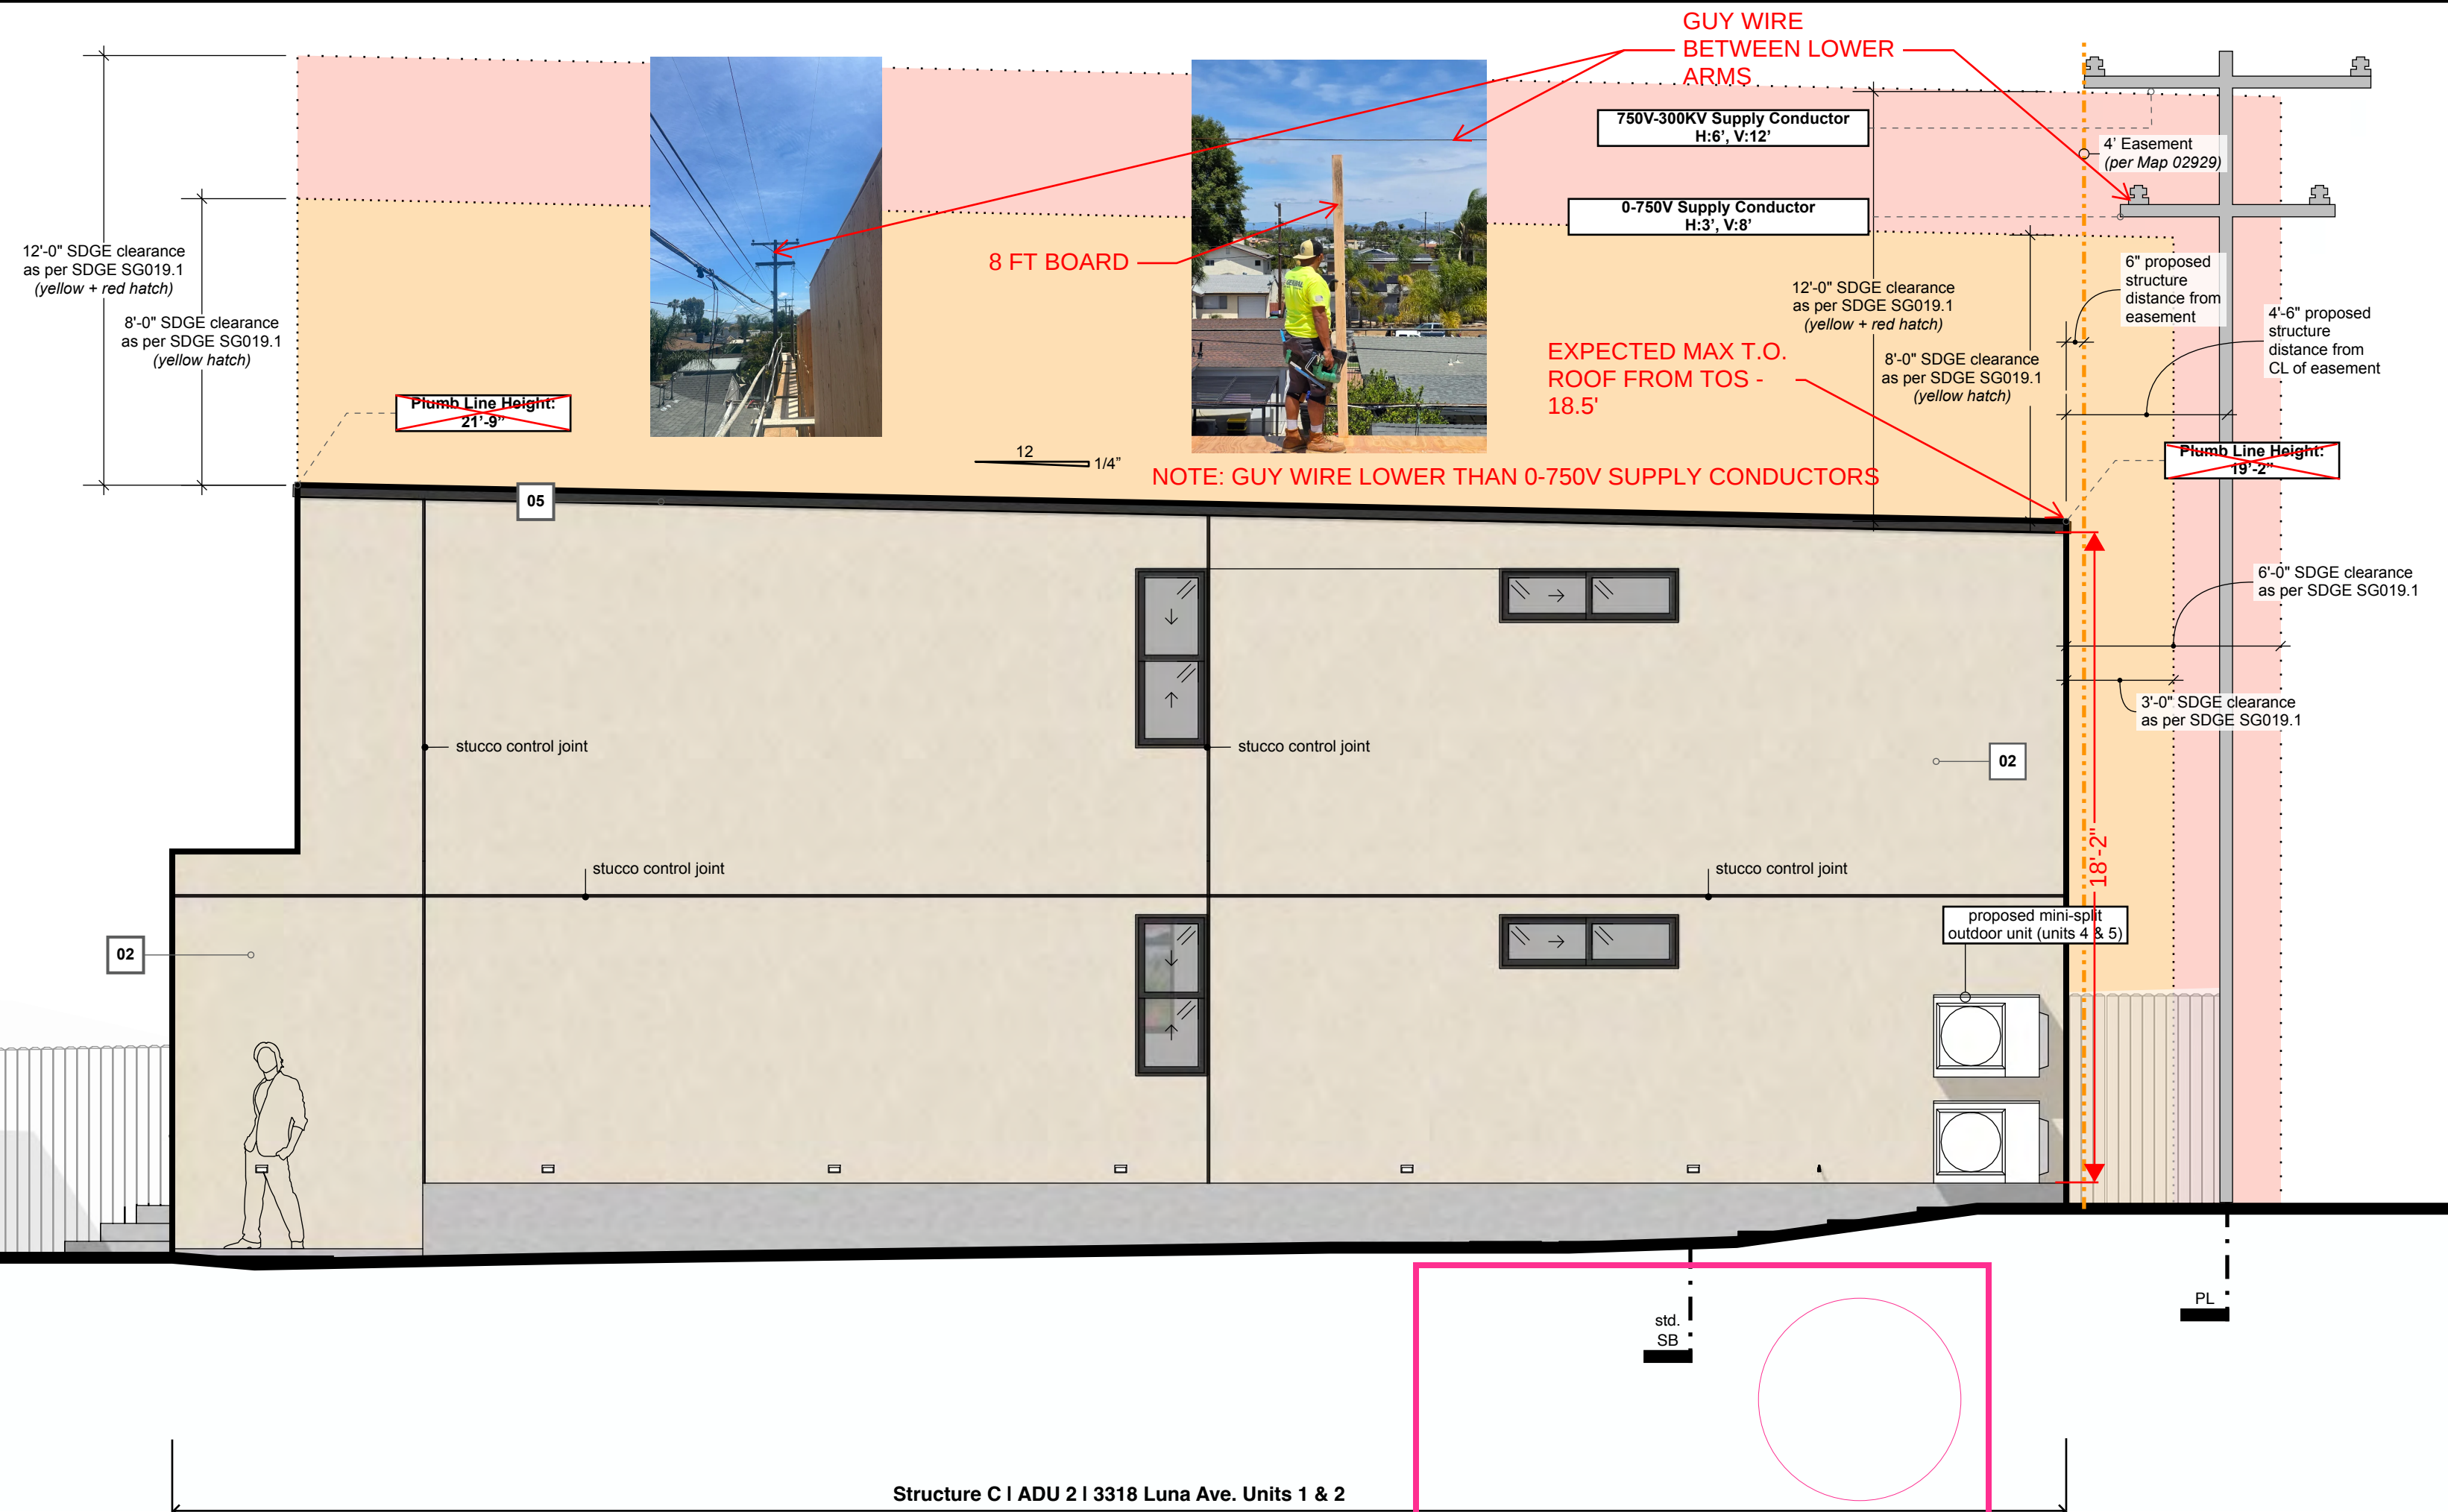


A340.

a

Table For Openings In Exterior Walls (340.A)
(R-3 Occupancy)

Floor	Fire Separation Distance	Wall Area	Opening Area	% of Total Proposed	% of Total Allowed
1	0' to less than 3'	56.5sf	0sf	0%	0%
	3' to less than 5'	163.5sf	38.5sf	23.5%	25%
	5' or greater	n/a	n/a	n/a	unlimited
2	0' to less than 3'	56.5sf	0sf	0%	0%
	3' to less than 5'	163.5sf	38.5sf	23.5%	25%
	5' or greater	n/a	n/a	n/a	unlimited




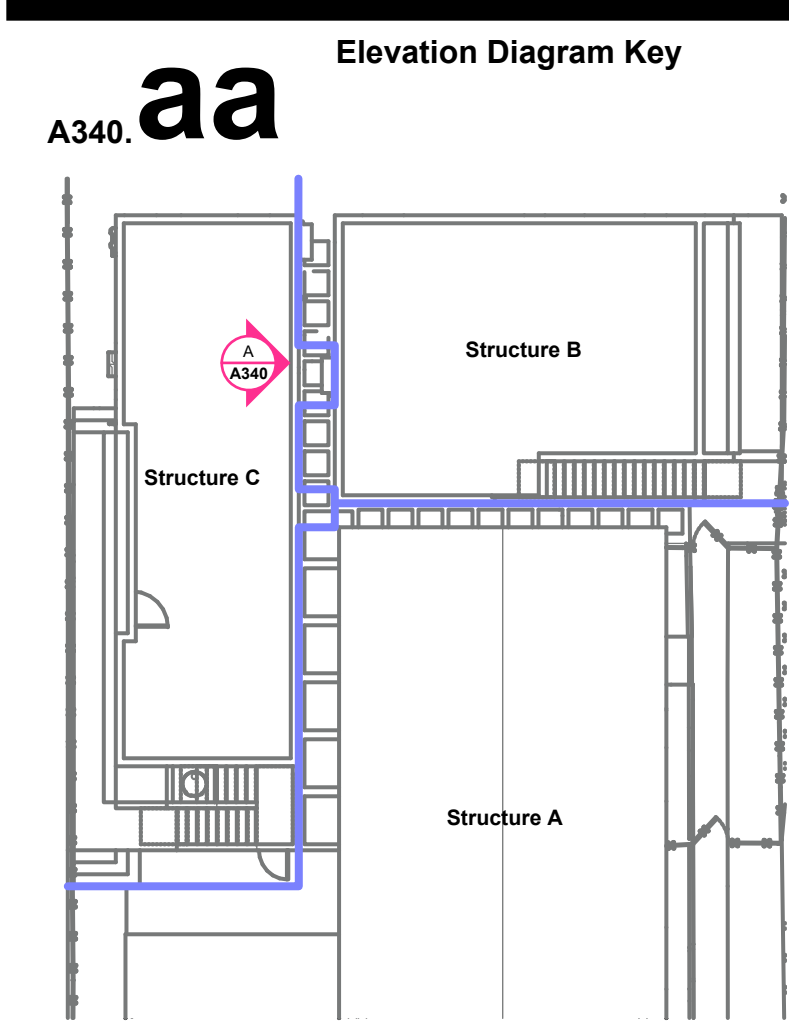


A340.

b

Table For Openings In Exterior Walls (340.B)
(R-3 Occupancy)

Floor	Fire Separation Distance	Wall Area	Opening Area	% of Total Proposed	% of Total Allowed
1	0' to less than 3'	410.5sf	0sf	0%	0%
	3' to less than 5'	75sf	16.5sf	22.0%	25%
	5' or greater	n/a	n/a	n/a	unlimited
2	0' to less than 3'	393.0	0sf	0%	0%
	3' to less than 5'	76.5sf	17.5sf	22.9%	25%
	5' or greater	n/a	n/a	n/a	unlimited

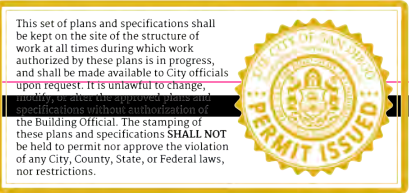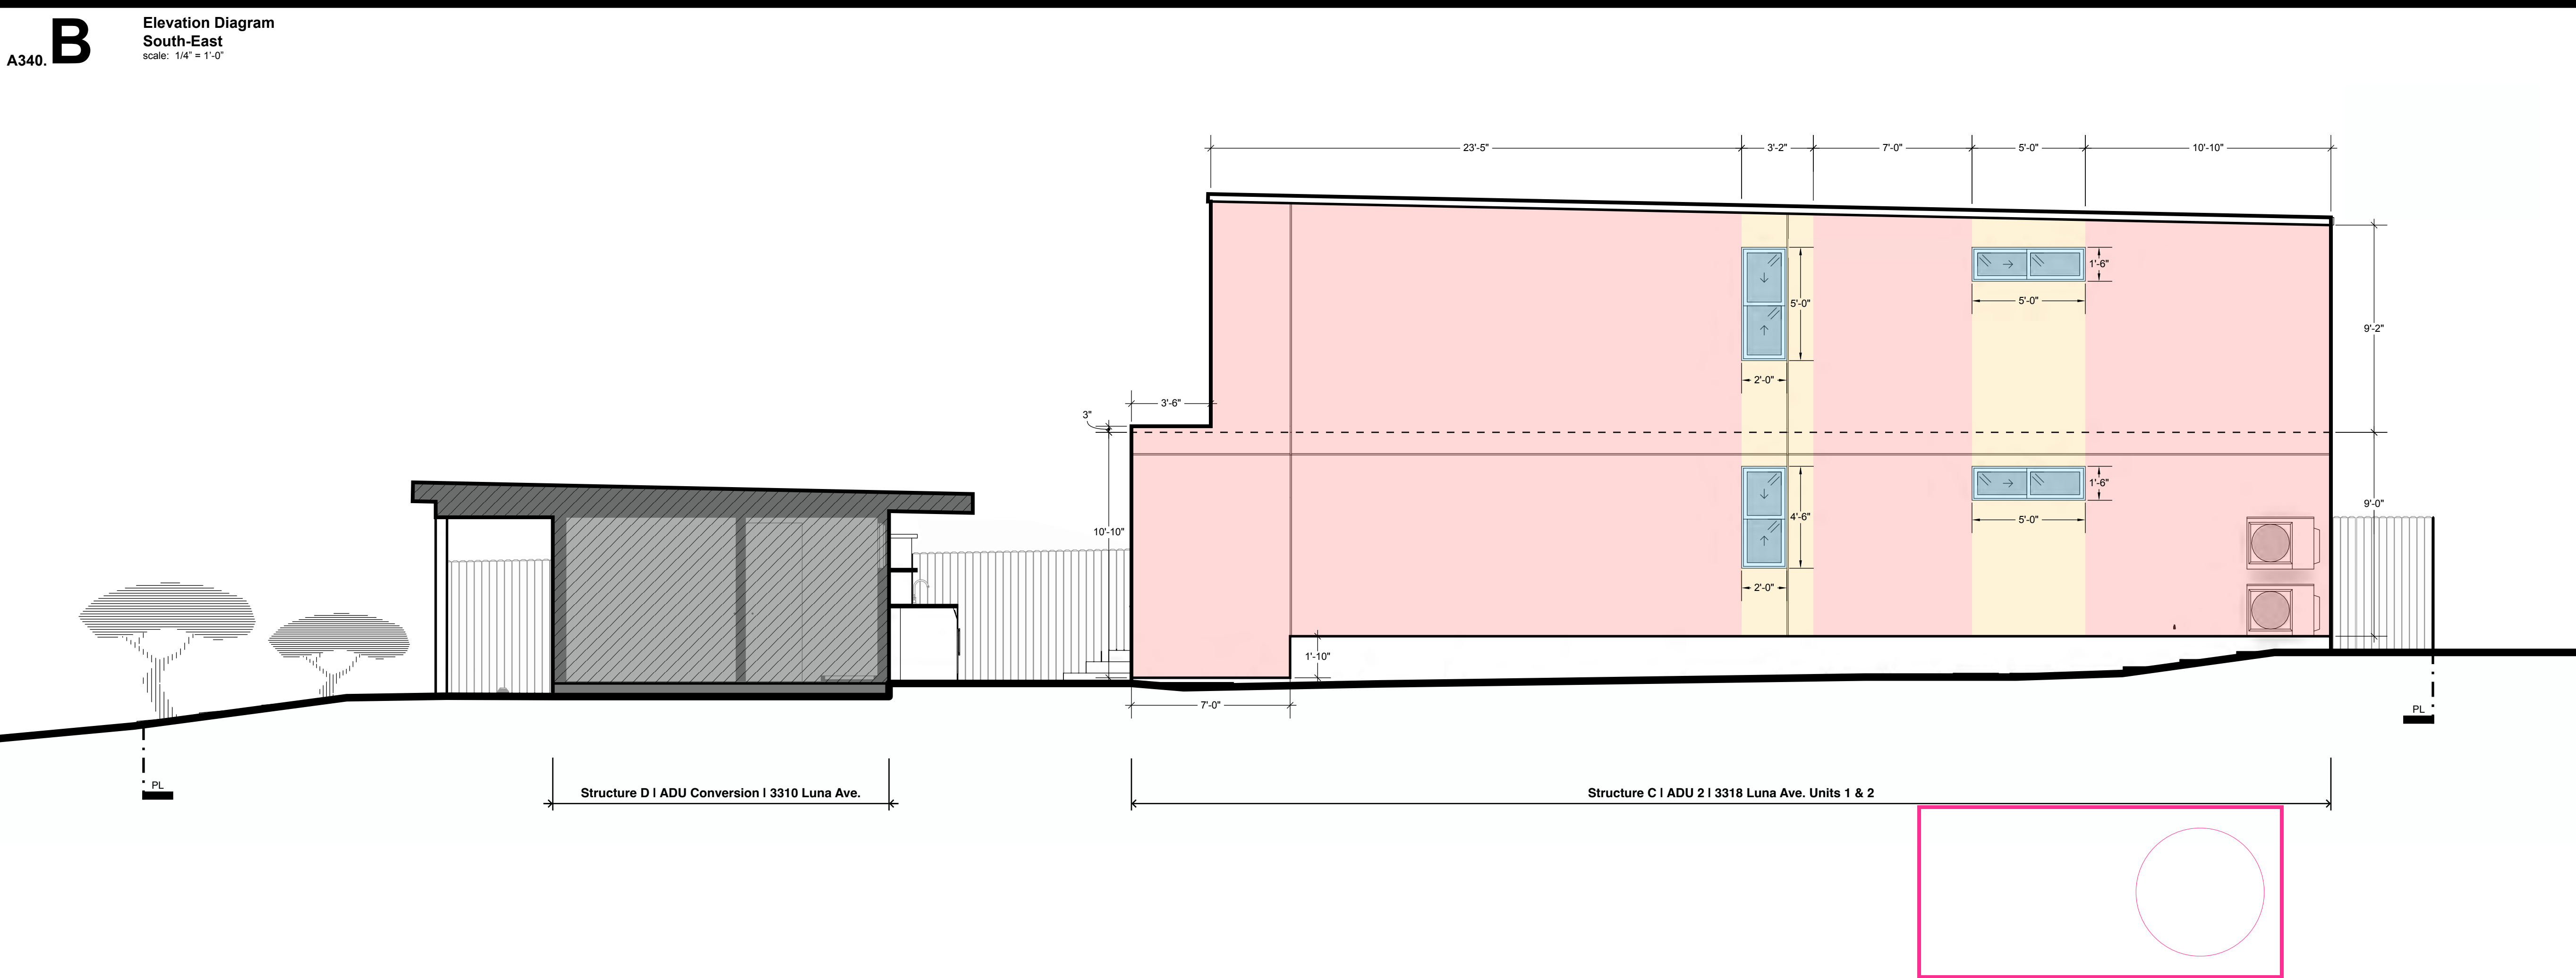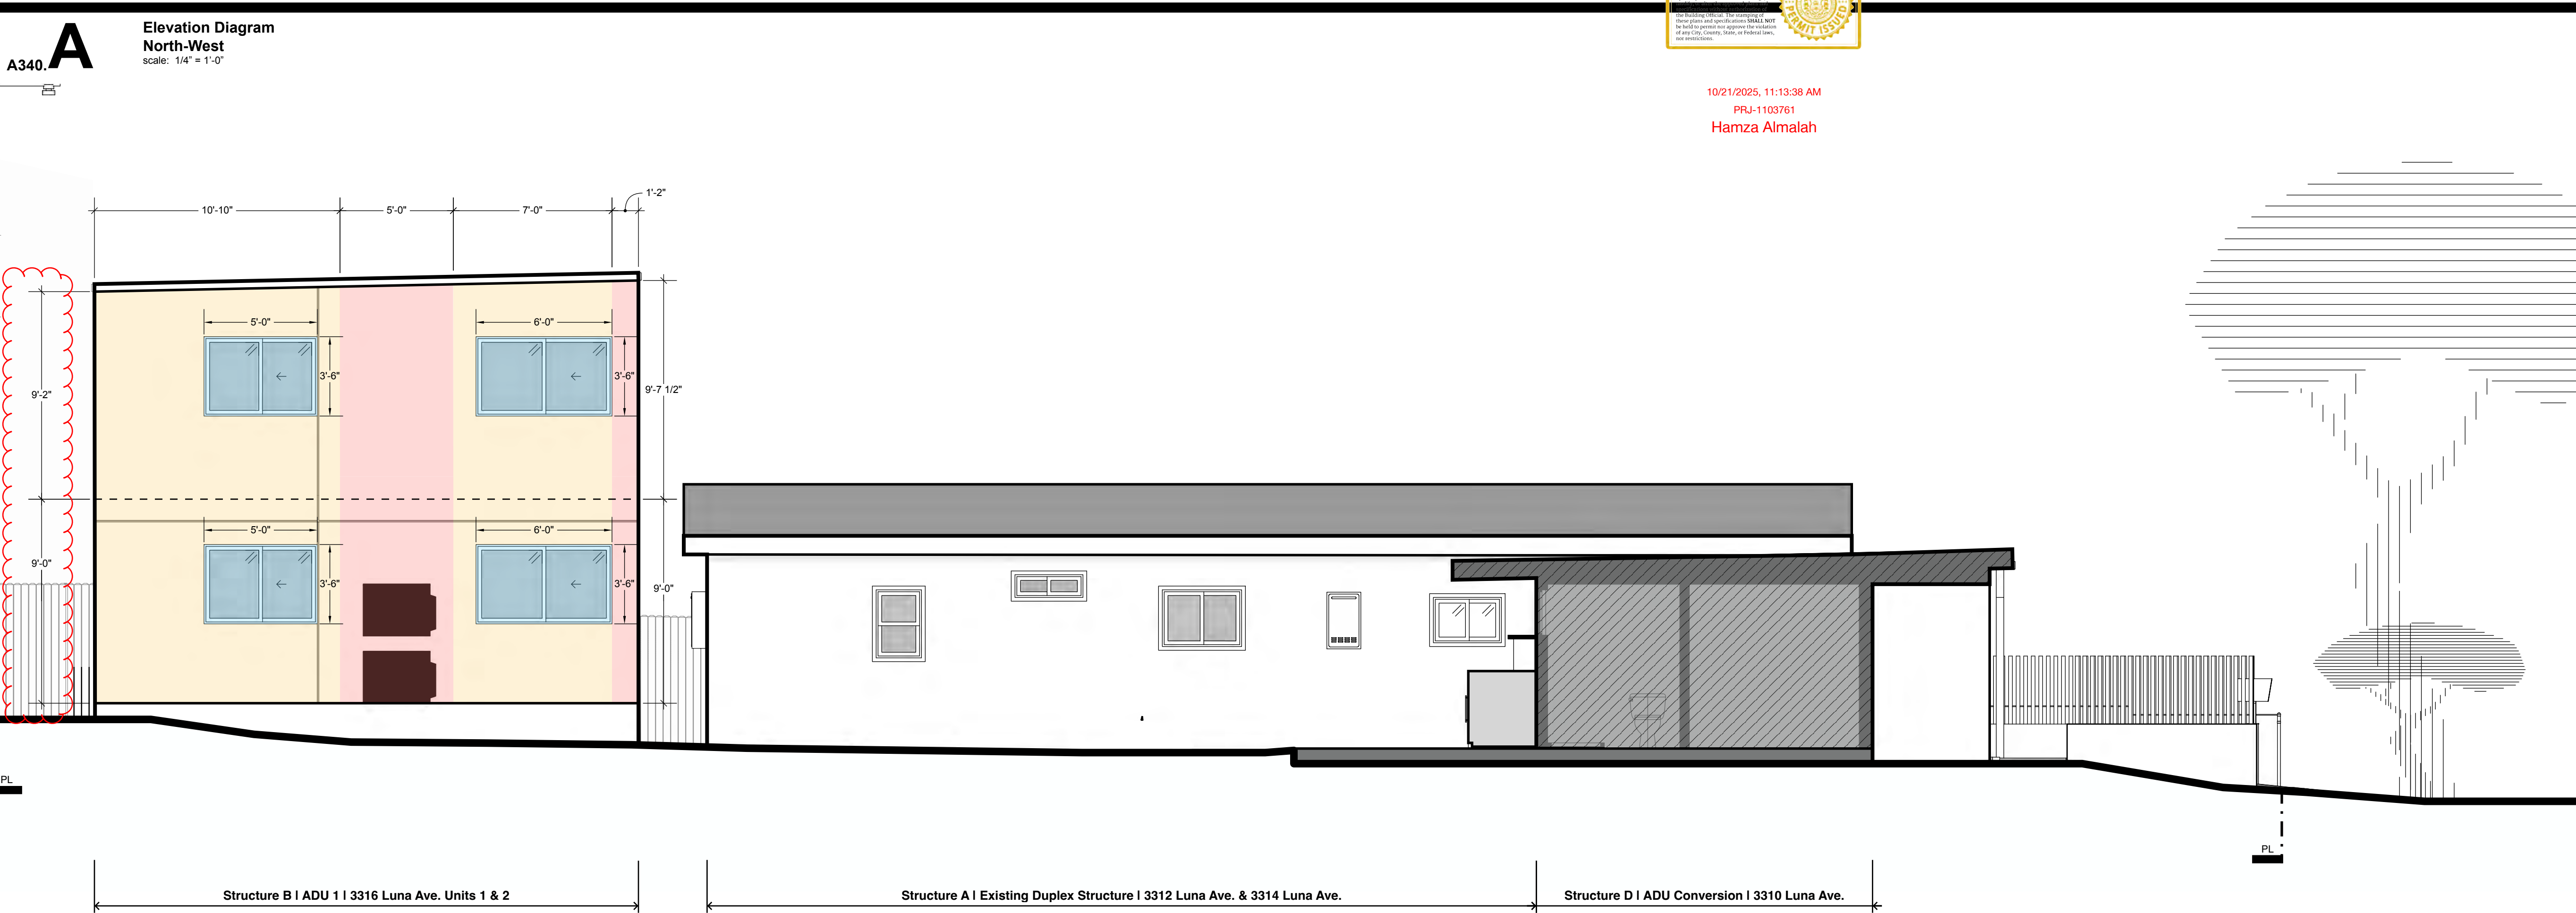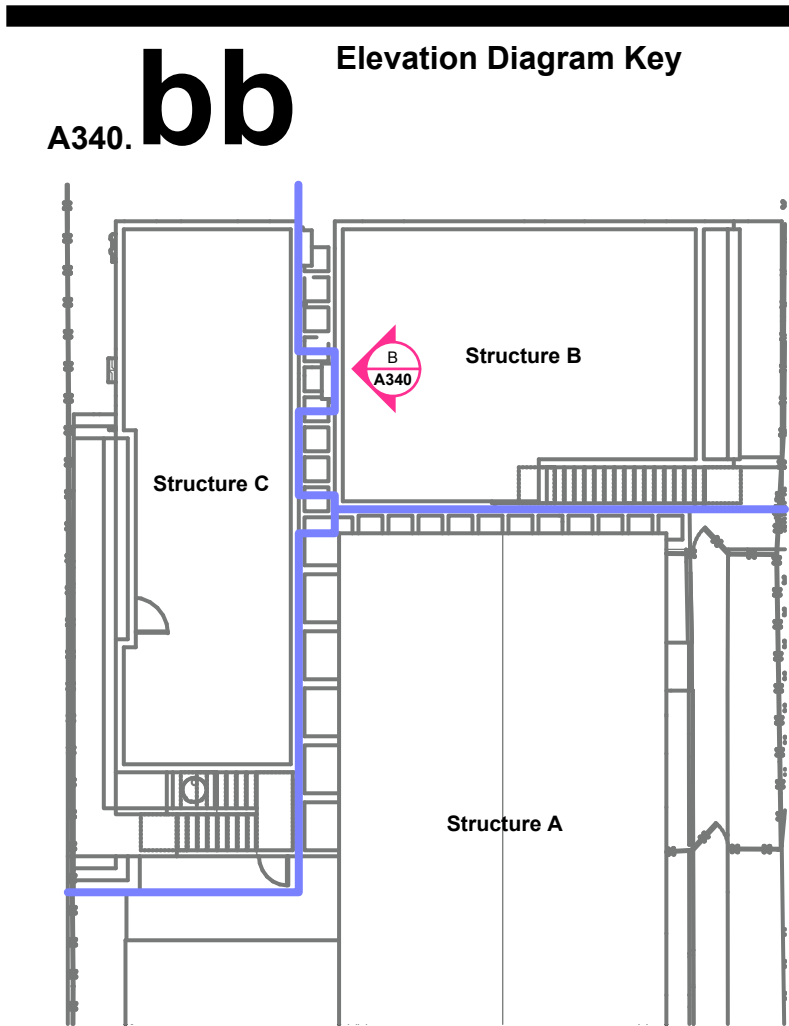

10/21/2025, 11:13:38 AM
PRJ-1103761
Hamza Almalah

PROJECT
Existing: 3312, 3314, Luna Ave. San Diego, CA 92117
Proposed: 3310, 3316, 3318 Luna Ave. San Diego, CA 92117

CLIENT
Michael + Paige Walker
4720 Luccasian Pl.
San Diego, CA 92117

DESCRIPTION
CONSTRUCTION CHANGE TABLE

DATE

DELTA #

ARCHITECTURE
tenseventyarchitecture.com
Ten Seventy Architecture
4411 30th St.
Suite 202
San Diego, CA 92116

drawn by: NGD
09.23.2025

ISSUE

DRAWING STATUS
AS BUILT DRAWINGS
PRELIMINARY DRAWINGS
PLAN CHECK DRAWINGS
CONSTRUCTION DOCUMENTS

DESCRIPTION
Elevation Diagram(s)

A340