


0 Elevation Schedule		
A310.		
Contractor to confirm all exterior colors w/ Owner prior to ordering material / performing work. Proposed colors represents Architect's recommendations (unless project is located in district which controls exterior colors).		
Exterior Materials	Minimum Values	
01	existing stucco to remain //	Fire Rating: 1 hr
02	new stucco Omega Diamond Wall Three Coat System, Santa Barbara or Fine Sand texture, Color-Tek finish, Color by Owner	Fire Rating: 1 hr UL 263
03	new standard CMU block stem wall. Refer to structural & A500 detail sheets.	Fire Rating: n/a
04	existing fascia	Fire Rating: n/a
05	new fascia	Fire Rating: n/a
06	new vertical composite siding JamesHardie Aspyre Collection Artisan Shiplap Siding, Color by Owner	Fire Rating: n/a
07	new stucco Omega Diamond Wall Three Coat System, Finish to match Other New Stucco, Color to Match New Facia	Fire Rating: 1 hr UL 263

A310. 4 Elevation - Structure B South-East
scale: 1/4" = 1'-0"


LEGEND

- INDICATES SURVEYED BUILDING DATA
- INDICATES SURVEYED POWER POLE/LINE DATA
- INDICATES CALCULATED CLEARANCE DATA
- INDICATES PROPOSED DATA PER PLAN*
- *PORTION OF BUILDING DID NOT EXIST AT TIME OF SURVEY

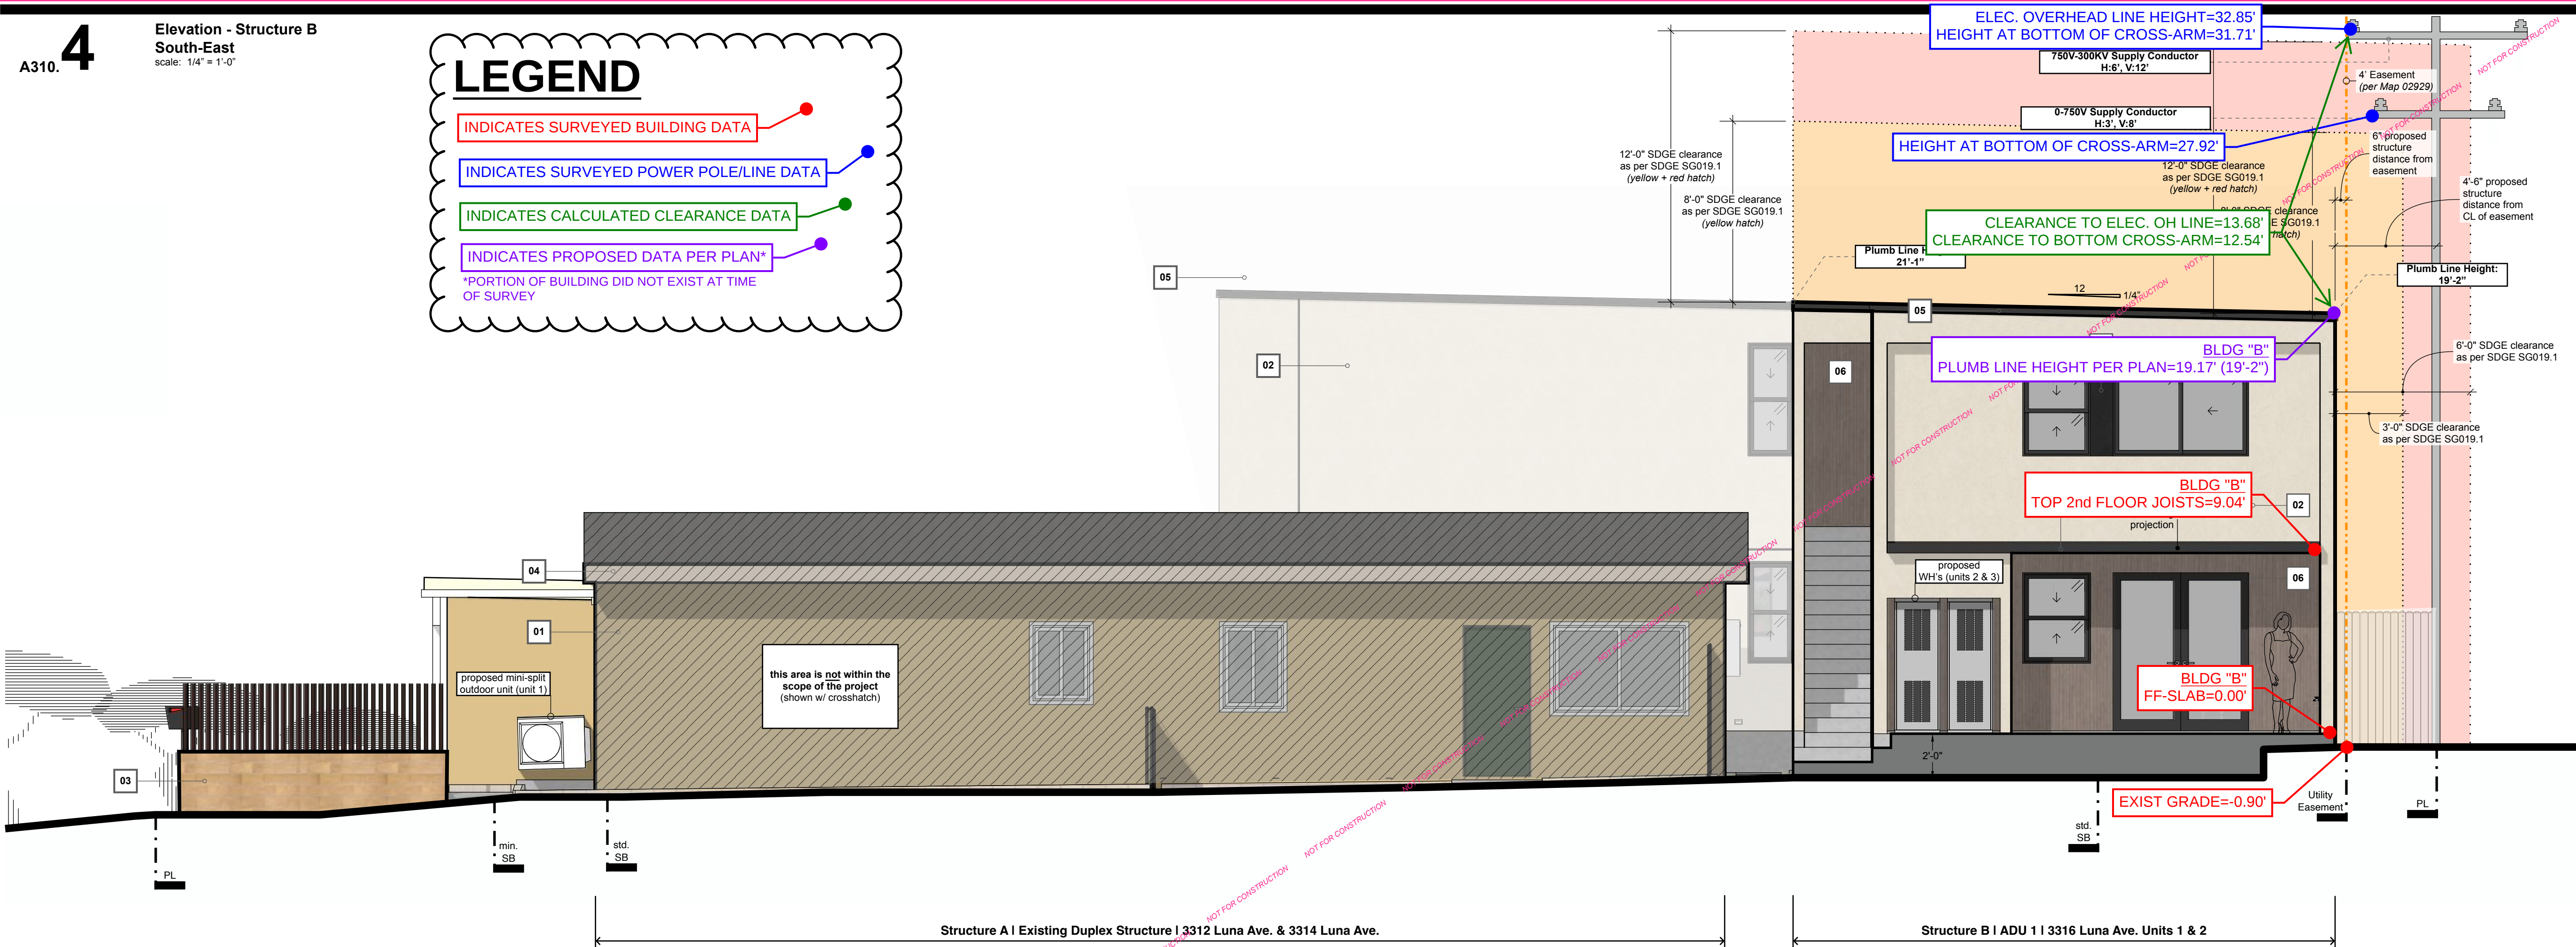

00 Reference Sheets		
A310.		
(If provided)		
Fire Rating		
see A500 sheets for Fire Rating certification/ tests for all materials listed with fire rating.		
Mechanical Fixtures/Equipment		
see E100 Sheets for Mechanical Equipment Specifications		
Lighting		
see E200 Sheets for Exterior Lighting + Switch Locations		

A310. 5 Elevation - Structure C South-East
scale: 1/4" = 1'-0"

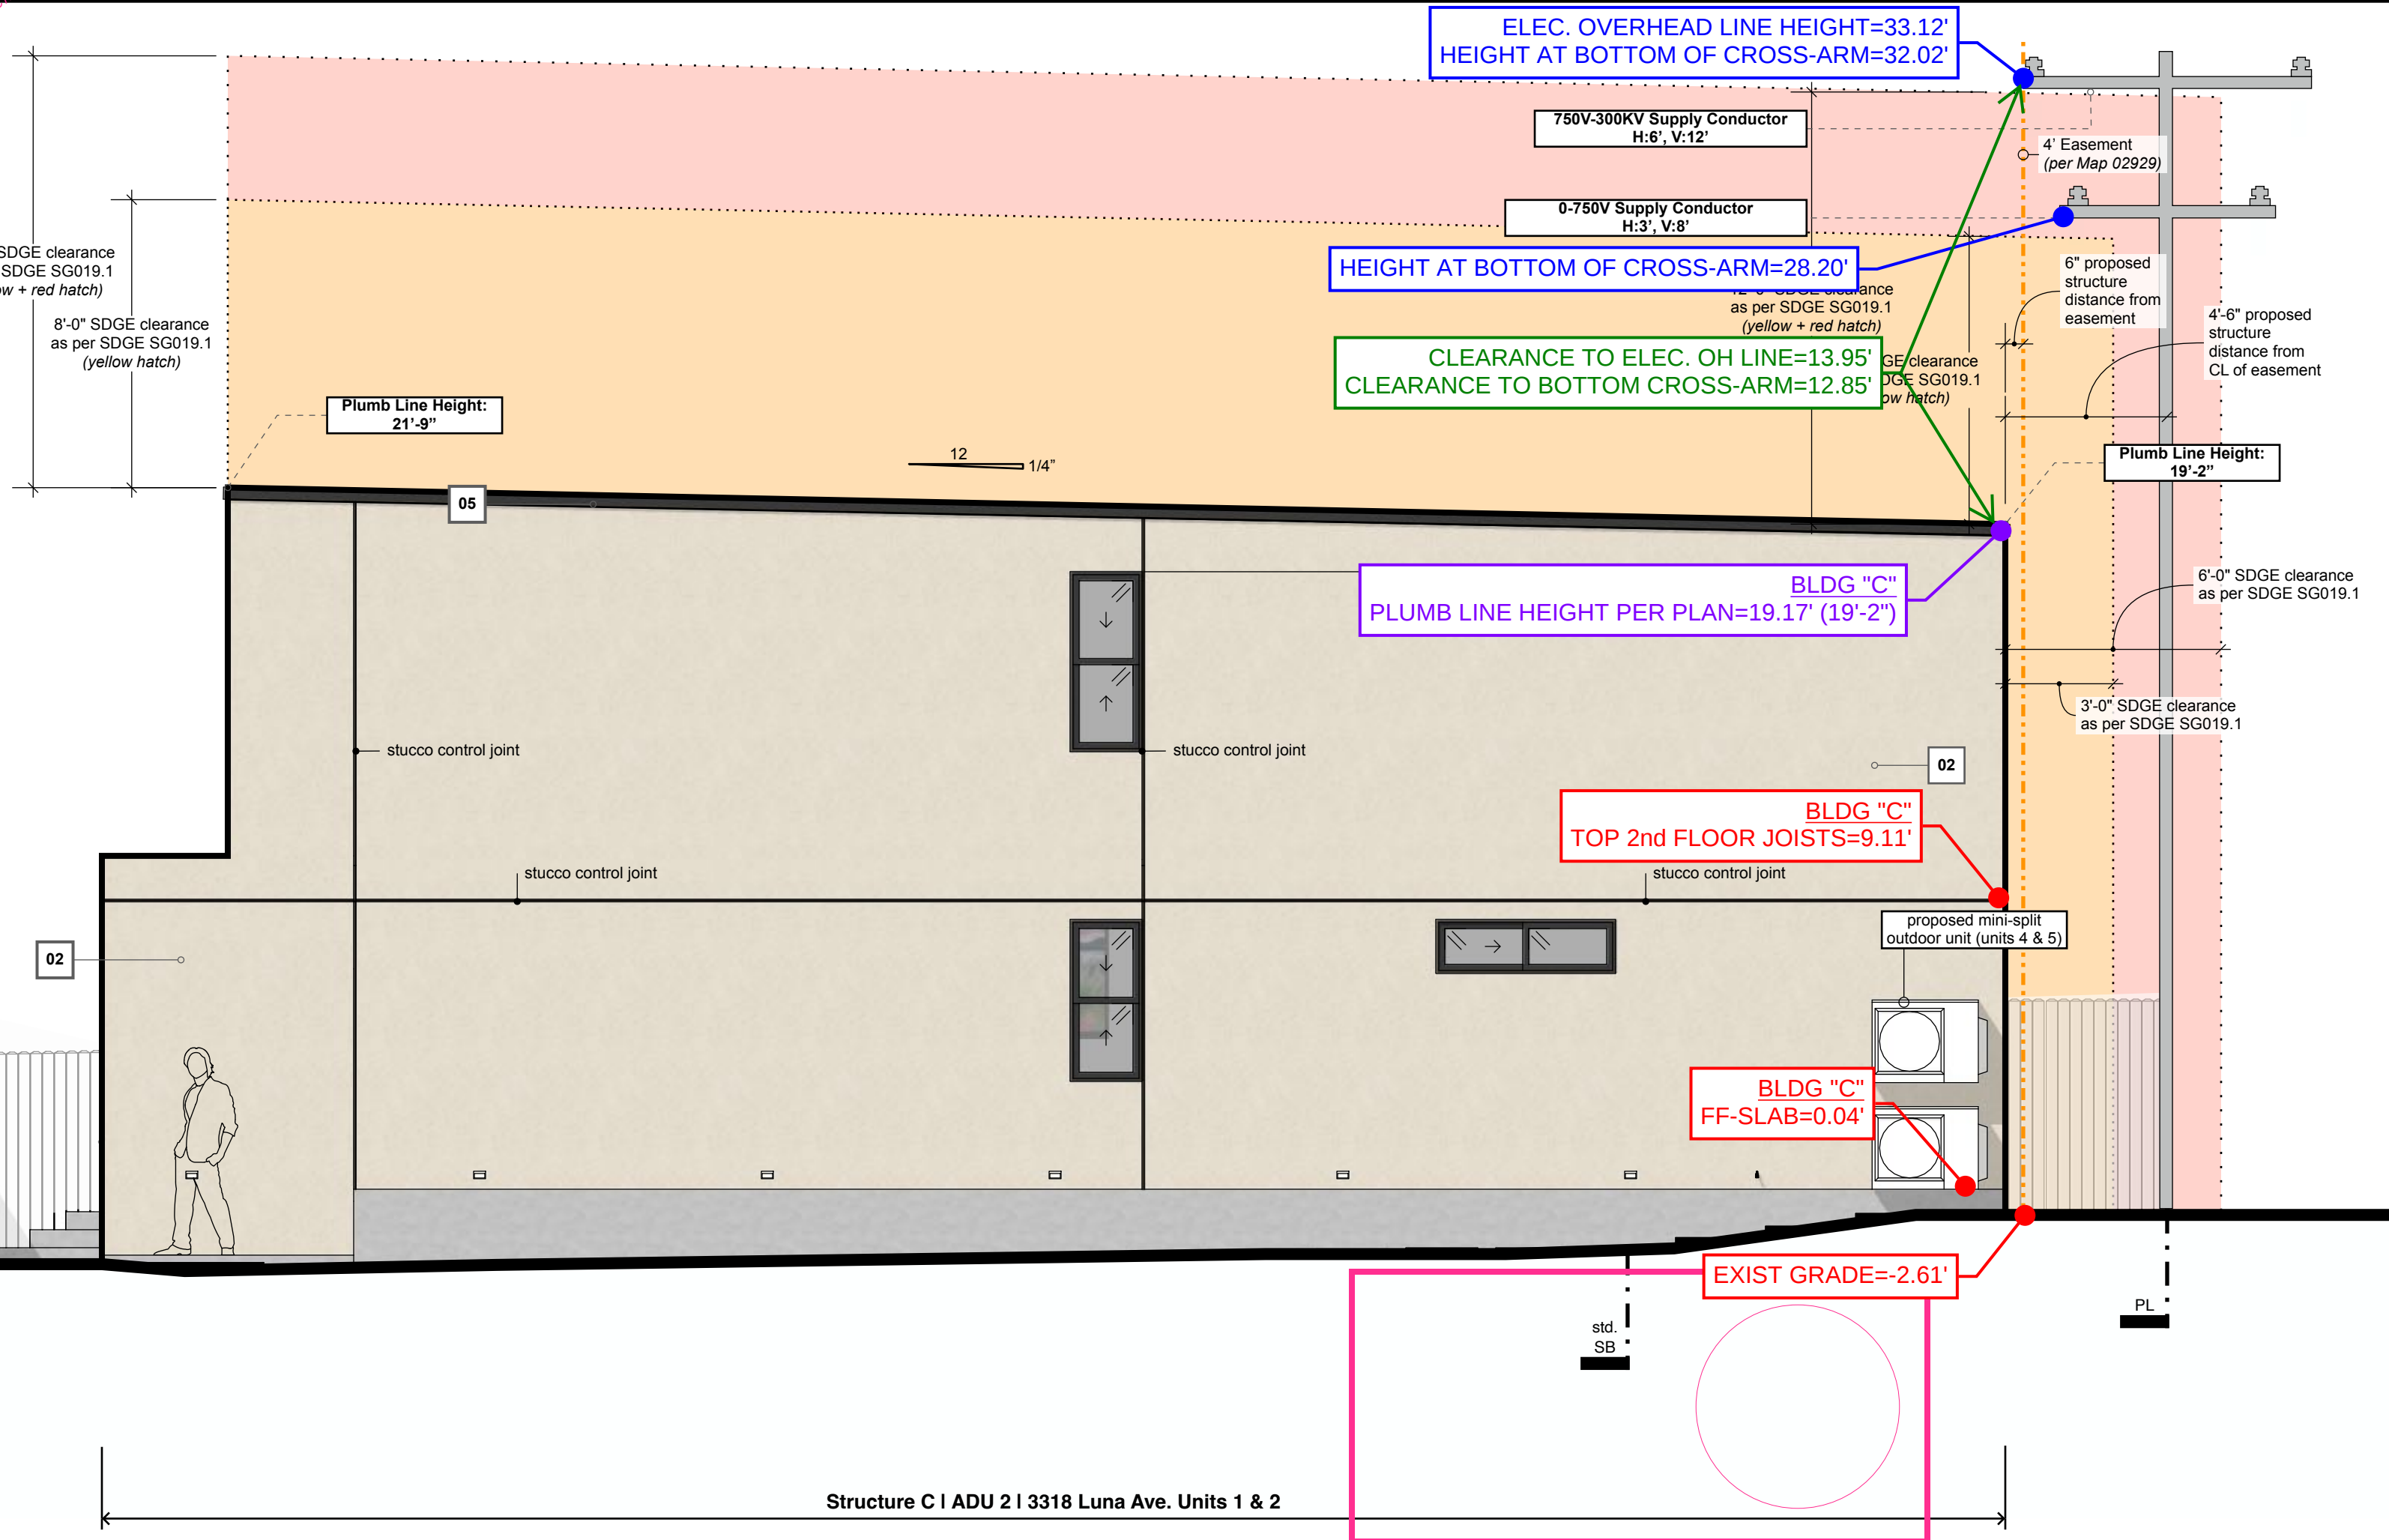

COFFMAN LAND CONSULTING, INC.
(JN: 26045)
- FIELD SURVEY PERFORMED
APRIL 7 & 10, 2026

PROJECT

CLIENT

DESCRIPTION

DATE

DELTA #

CONSTRUCTION CHANGE TABLE

LICENSED ARCHITECT
C-33066
STATE OF CALIFORNIA

lenseventyarchitecture.com
Ten Seventy Architecture
4411 30th St.
Suite 202
San Diego, CA 92116

TEN SEVENTY
ARCHITECTURE

ARCHITECTURE

drawn by: NGD
09 12 2025

ISSUE

AS BUILT DRAWINGS
PRELIMINARY DRAWINGS
PLAN CHECK DRAWINGS
CONSTRUCTION DOCUMENTS

DRAWING STATUS

Elevations:
South-East

DESCRIPTION

A310